

West Michigan Shoreline Regional Development Commission

Mill Debris Fish & Wildlife Restoration

Muskegon County, Michigan
November 2018 - Record Drawings

AS-BUILT	
CONTRACTOR:	RUSSELL MARINE LLC
FIELD ENGINEER:	RICK BUTEYN
INSPECTED BY:	PROGRESSIVE AE
DATE:	09/27/2018

- DRAWING INDEX
- 1 COVER SHEET
 - 2 LOCATION MAP
 - 3 EXISTING CONDITIONS
 - 4 SESC
 - 5 PROPOSED CONDITIONS
 - 7 CROSS-SECTIONS: DREDGE AREA A
 - 8 CROSS-SECTIONS: DREDGE AREA B



MICHIGAN STATE MAP
NOT TO SCALE



VICINITY MAP
NOT TO SCALE

SOURCE: <http://www.maps.google.com>




ATTENTION:	11/27/2018	RECORD DRAWINGS	
	08/16/2018	PERMIT MODIFICATION	
	02/06/2018	BIDS & CONSTRUCTION	
	01/12/2018	OWNER REVIEW	
	11/17/2017	OWNER REVIEW	
	07/06/2017	DESIGN MODIFICATION	APP
	04/07/2017	CONSTRUCTION DOCUMENTS	APP
NO.	DATE	ISSUE/REVISION	APP

Surveyed By:	Great Lakes Dock on 06/01/2016
	Progressive AE on 09/27/2018
Designed:	-
Checked:	-
Drawn:	-R. Dolweck
Submitted By:	- M. Oezer
M.I.P.E. NO.:	- 41016

Submitted Date:	
progressiveae	

WEST MICHIGAN SHORELINE
REGIONAL DEVELOPMENT COMMISSION
Progressive AE Project 7008004

MILL DEBRIS FISH & WILDLIFE HABITAT RESTORATION West Michigan Shoreline Regional Community Muskegon, Michigan	DWG NO. 1
COVER SHEET	ISSUE 0

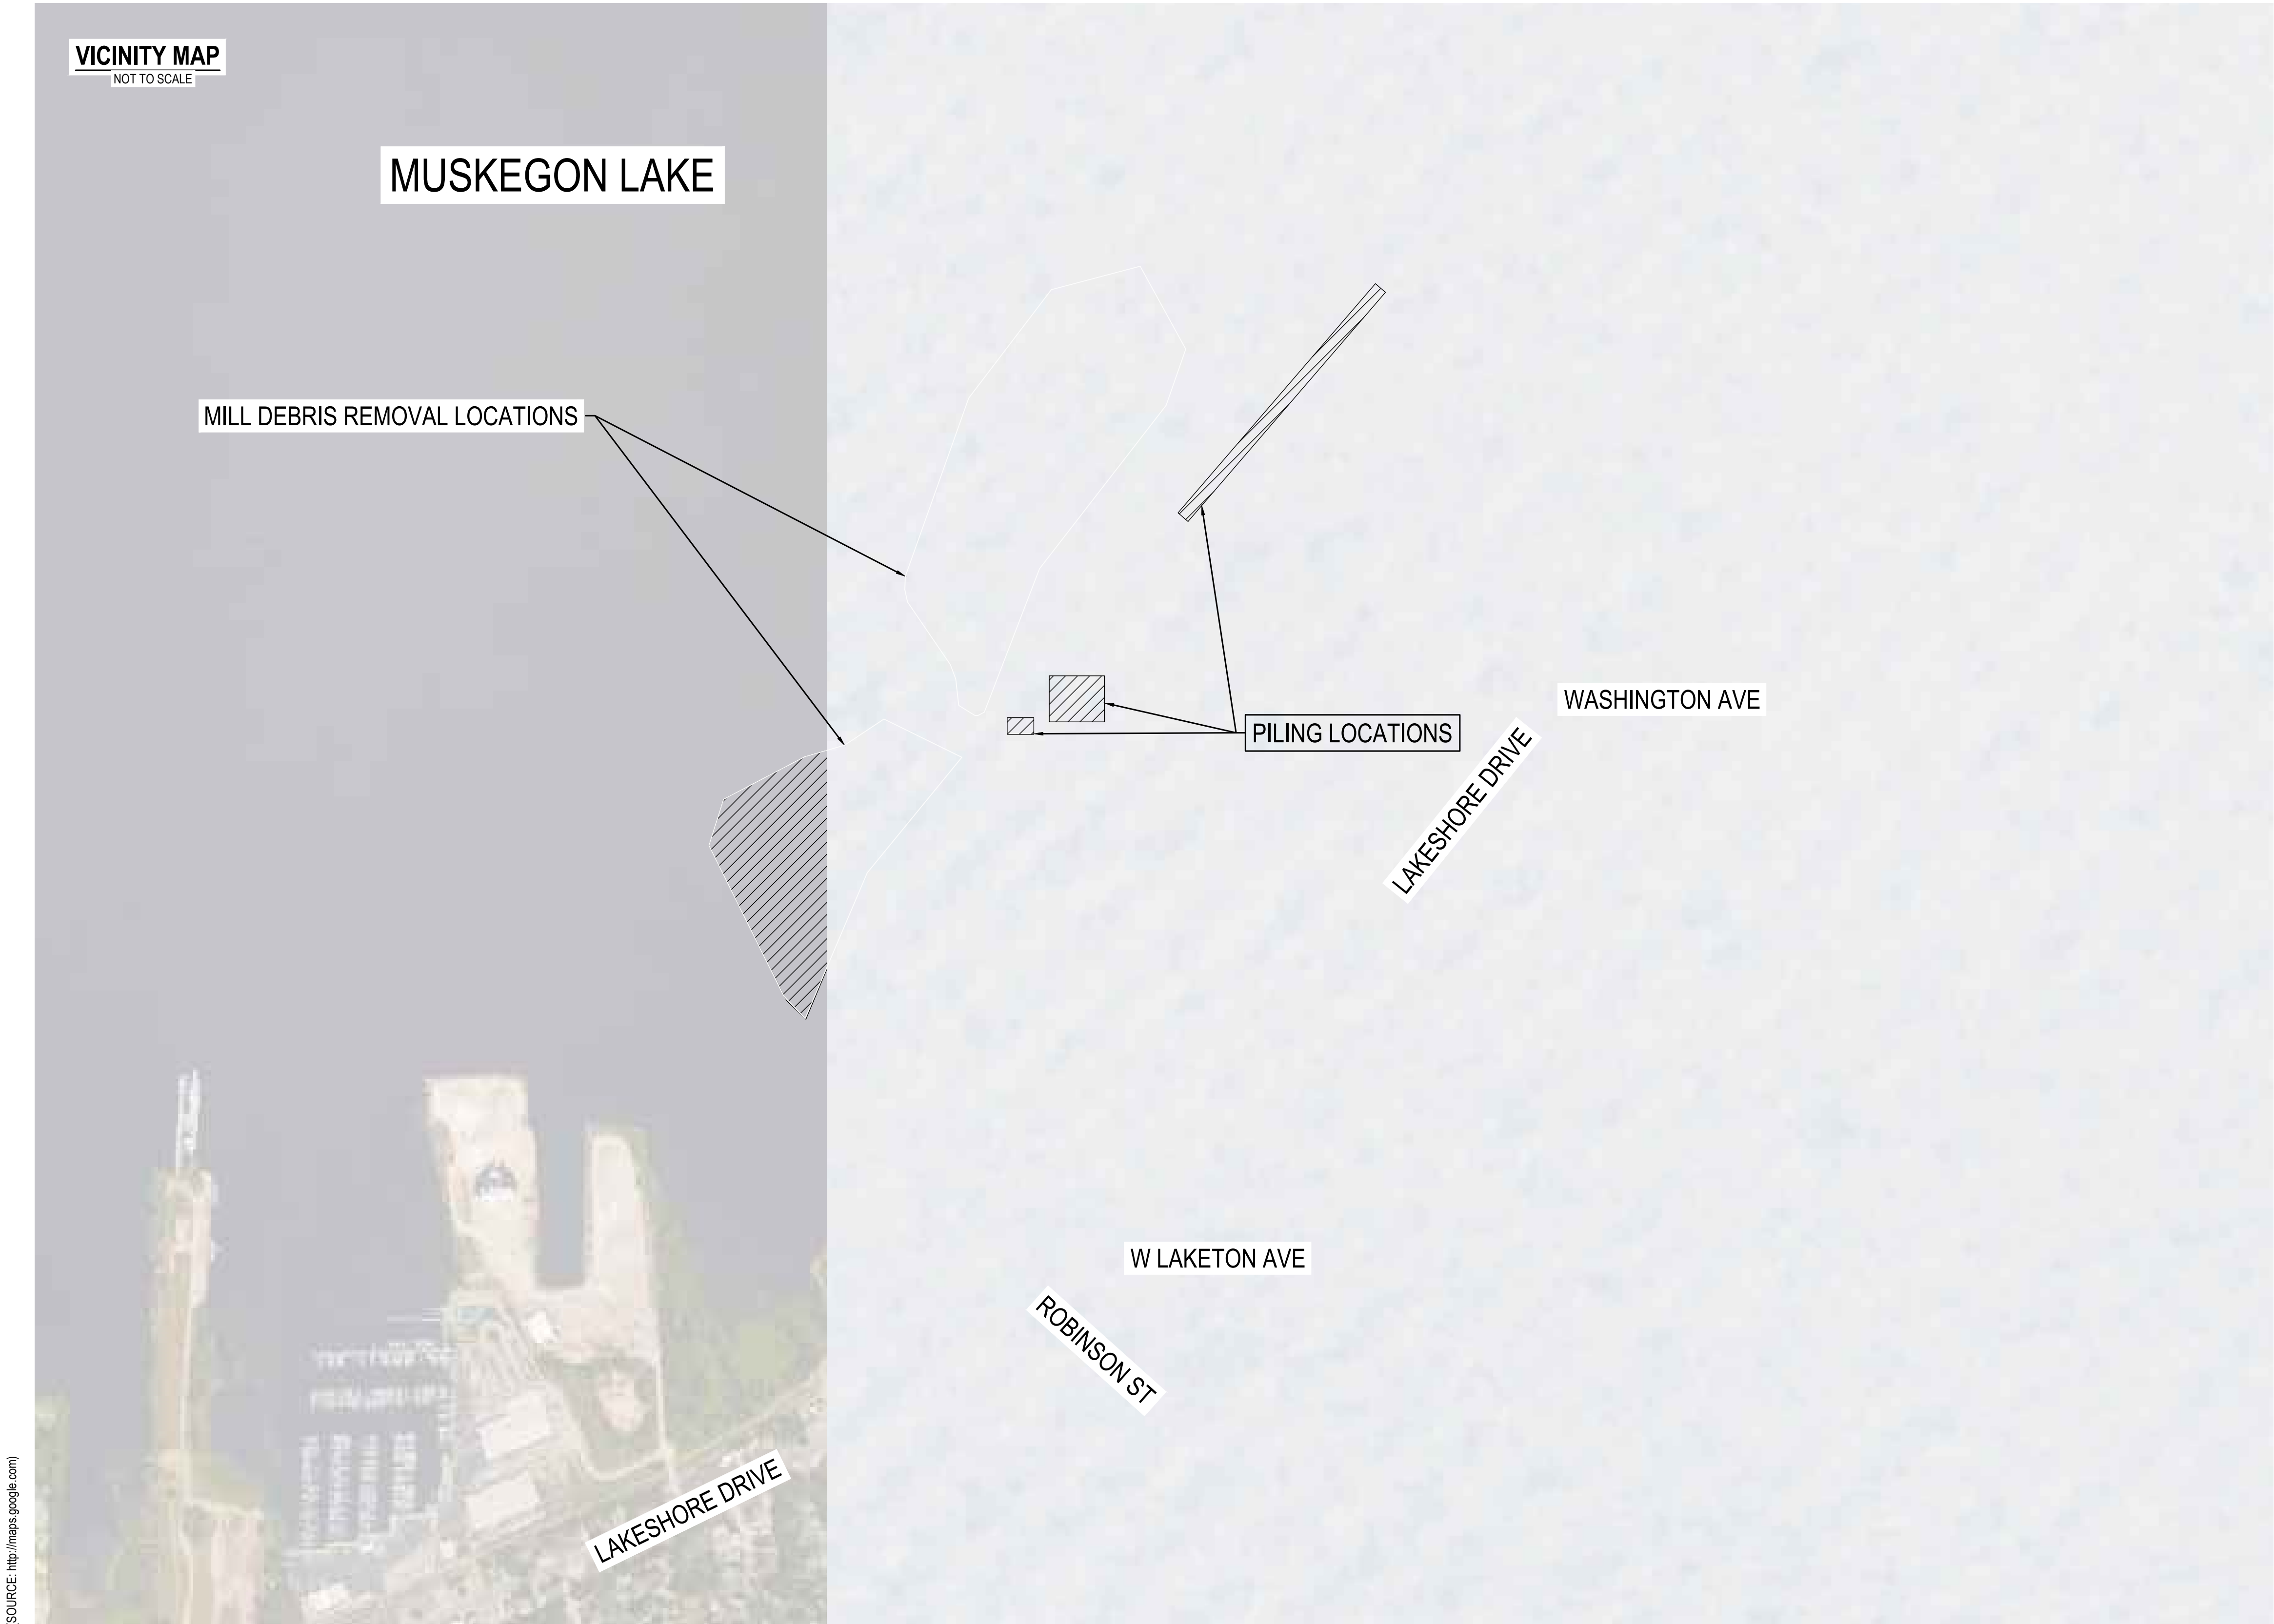

AS-BUILT	
CONTRACTOR:	RUSSELL MARINE LLC
FIELD ENGINEER:	RICK BUTEYN
INSPECTED BY:	PROGRESSIVE AE
DATE:	09/27/2018



ATTENTION: 0" = 1" If this scale bar does not measure 1" then drawing is not original scale.	11/27/2018	RECORD DRAWINGS	
	08/16/2018	PERMIT MODIFICATION	
	02/06/2018	BIDS & CONSTRUCTION	
	01/12/2018	OWNER REVIEW	
	11/17/2017	OWNER REVIEW	
	07/06/2017	DESIGN MODIFICATION	APP
	04/07/2017	CONSTRUCTION DOCUMENTS	APP
NO.	DATE	ISSUE/REVISION	APP

Surveyed By:	Great Lakes Dock on 06/01/2016 Progressive AE on 09/27/2018
Designed:	-
Checked:	-
Drawn:	-R. Dolweck
Submitted By:	- M. Oezer
MI P.E. NO.:	- 41016

Submittal Date:




Progressive AE Project 7008004

MILL DEBRIS FISH & WILDLIFE HABITAT RESTORATION
West Michigan Shoreline Regional Community
Muskegon, Michigan

LOCATION MAP

DWG NO.
2

ISSUE
0

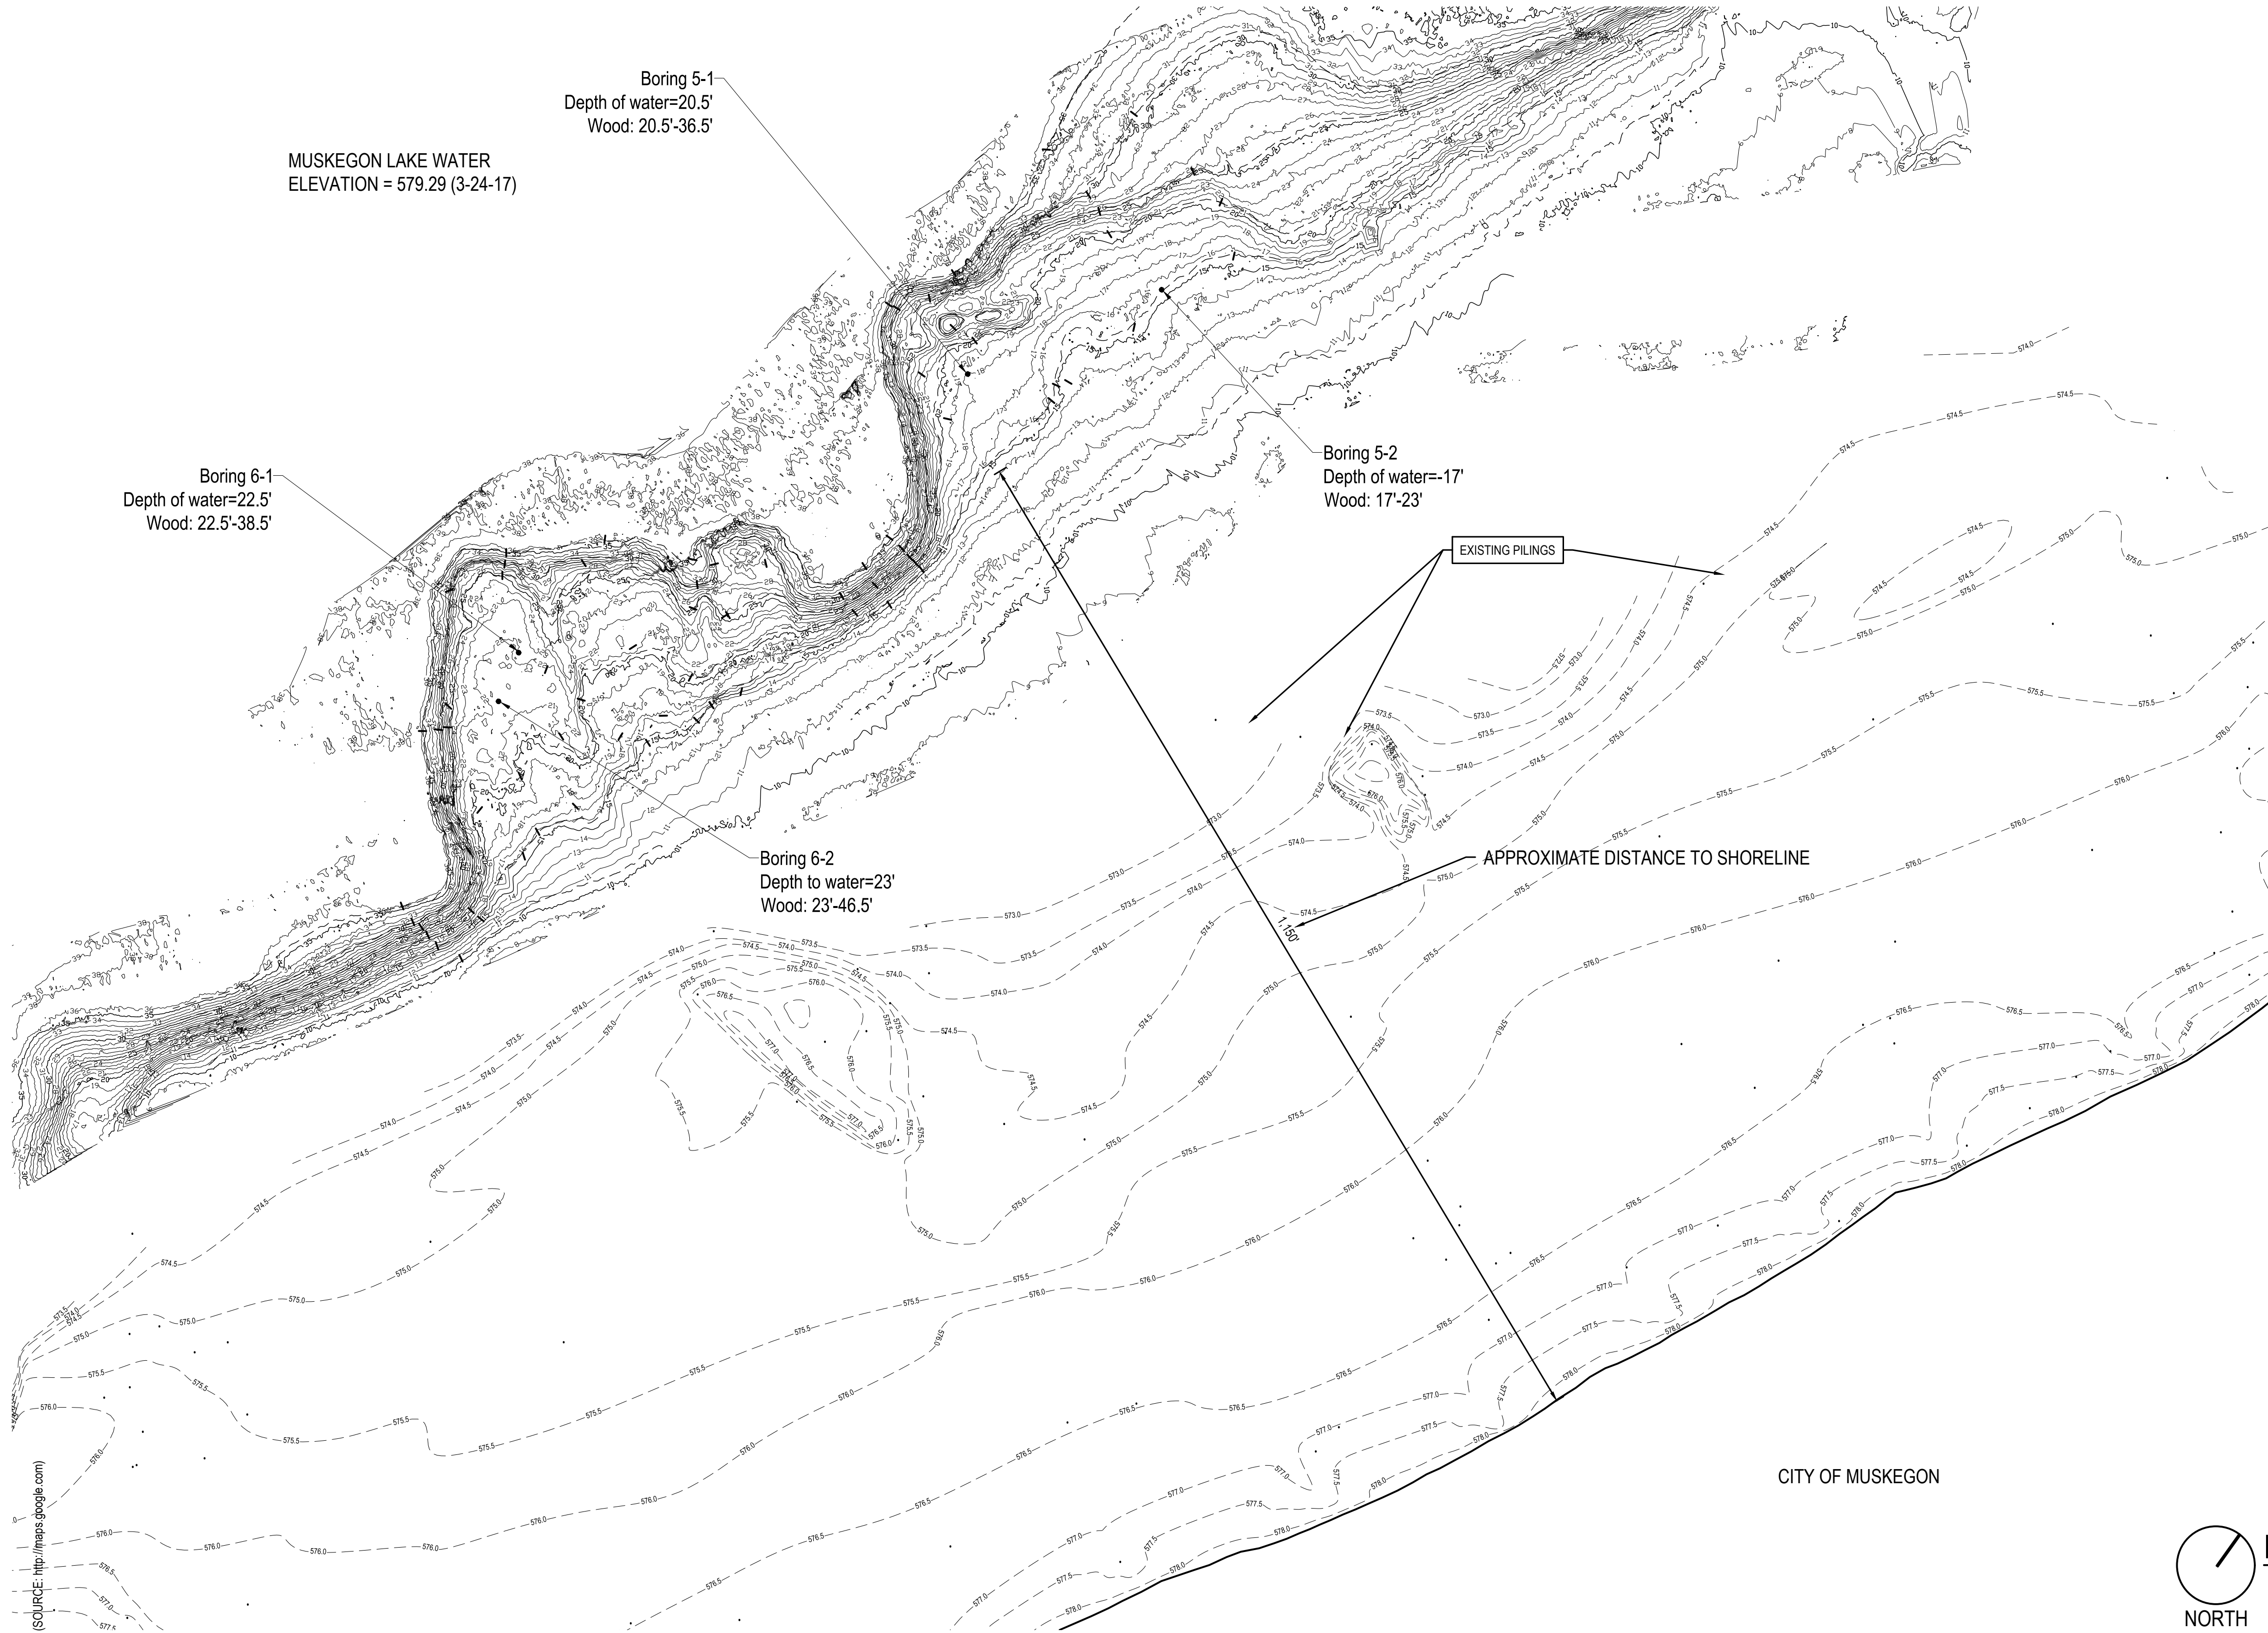

LEGEND

- 000 MAJOR CONTOUR - 5 FT. INTERVAL
- 001 MINOR CONTOUR - 1 FT. INTERVAL

NOTES

- 1) ORDINARY HIGH WATER MARK (OHWM) = 580.5'
- 2) ALL PROPERTY AND/OR RIGHT OF WAY LINES ARE APPROXIMATE.
- 3) TOPOGRAPHIC SURVEY PROVIDED BY RUSSELL MARINE ENGINEERING & DESIGN LLC ON 06/01/2016.
- 4) TOPOGRAPHY SHOWN BASED ON DEPTH BELOW WATER ON DAY OF TOPOGRAPHIC SURVEY (JUNE 1, 2016).
- 5) WATER ELEVATION ON JUNE 1, 2016 = 580.18'

AS-BUILT

CONTRACTOR:	RUSSELL MARINE LLC
FIELD ENGINEER:	RICK BUTEYN
INSPECTED BY:	PROGRESSIVE AE
DATE:	09/27/2018

EXISTING CONDITIONS



1"= 100'



ATTENTION:		11/27/2018	RECORD DRAWINGS	
		08/16/2018	PERMIT MODIFICATION	
		02/06/2018	BIDS & CONSTRUCTION	
		01/12/2018	OWNER REVIEW	
		11/17/2017	OWNER REVIEW	
	0	07/06/2017	DESIGN MODIFICATION	APP
	0	04/07/2017	CONSTRUCTION DOCUMENTS	APP
NO.	DATE	ISSUE/REVISION		APP

Surveyed By: Great Lakes Dock on 06/01/2016
Progressive AE on 09/27/2018

Designed: -
Checked: -
Drawn: -R. Dolweck
Submitted By: -M. Oezer
M.I.P.E. NO.: -41016

Submittal Date:




MILL DEBRIS FISH & WILDLIFE HABITAT RESTORATION
West Michigan Shoreline Regional Community
Muskegon, Michigan


EXISTING CONDITIONS

DWG NO.
3
ISSUE
0

(SOURCE: <http://maps.google.com>)

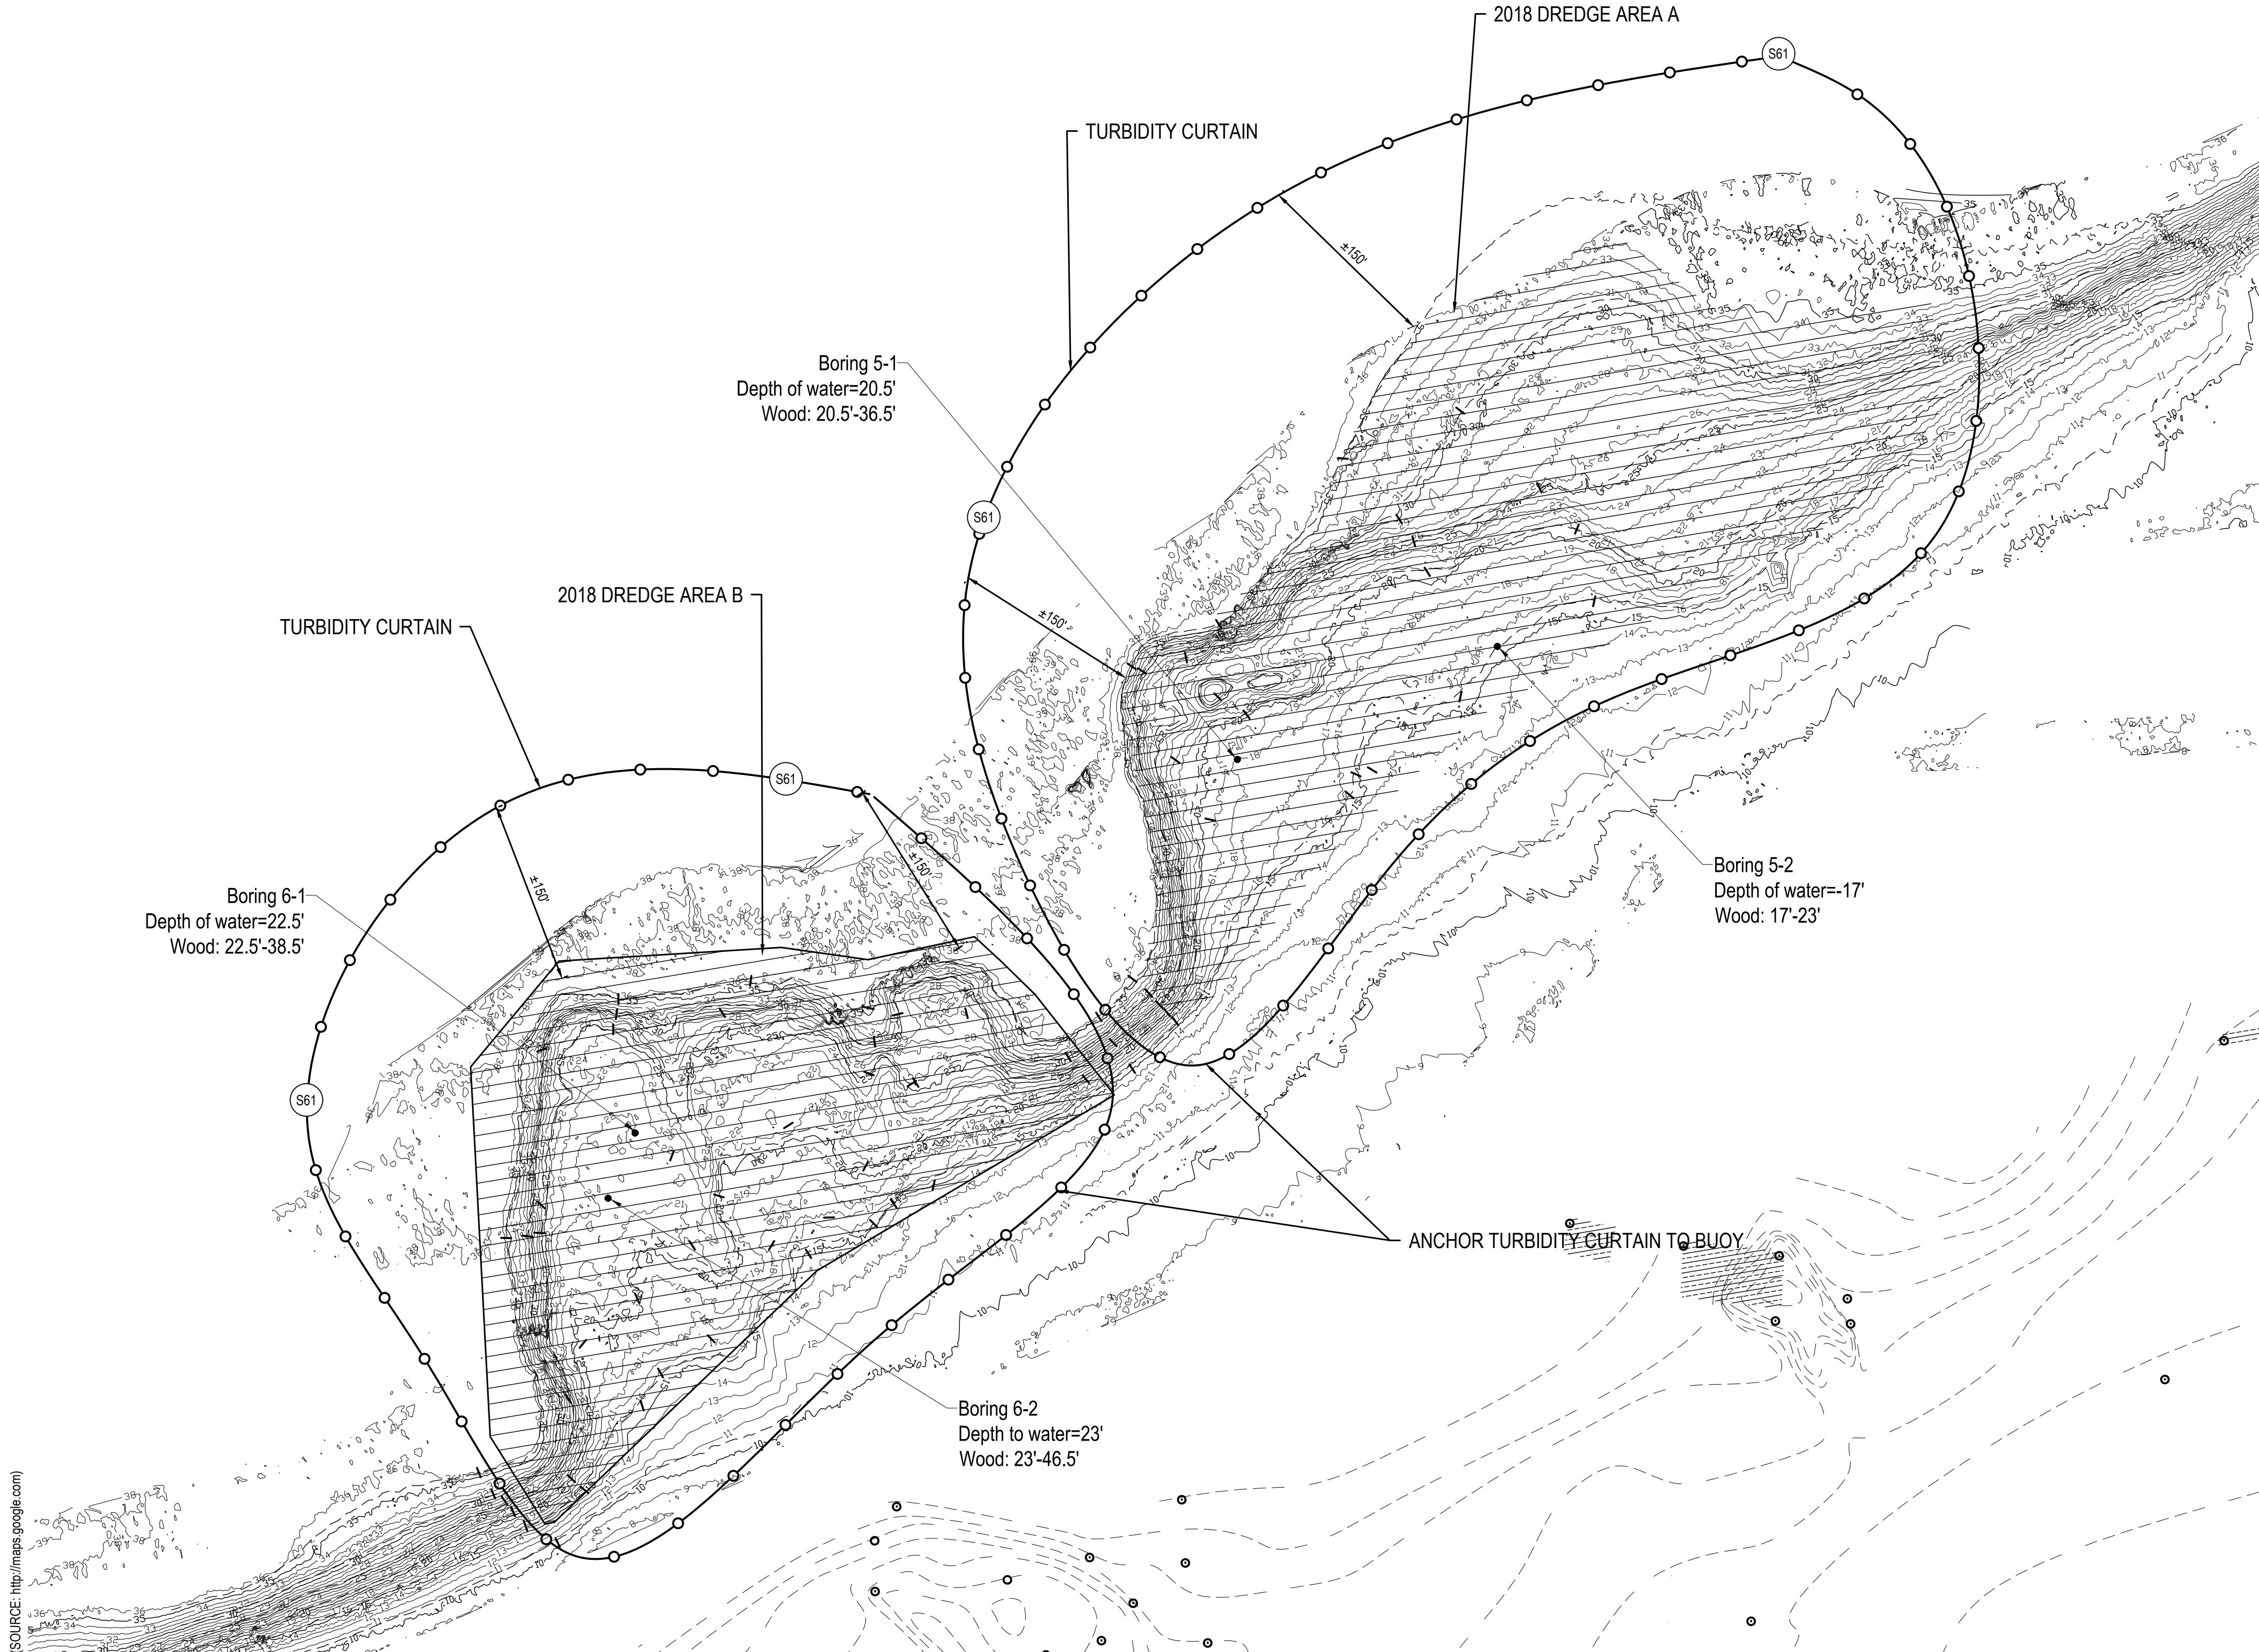

LEGEND

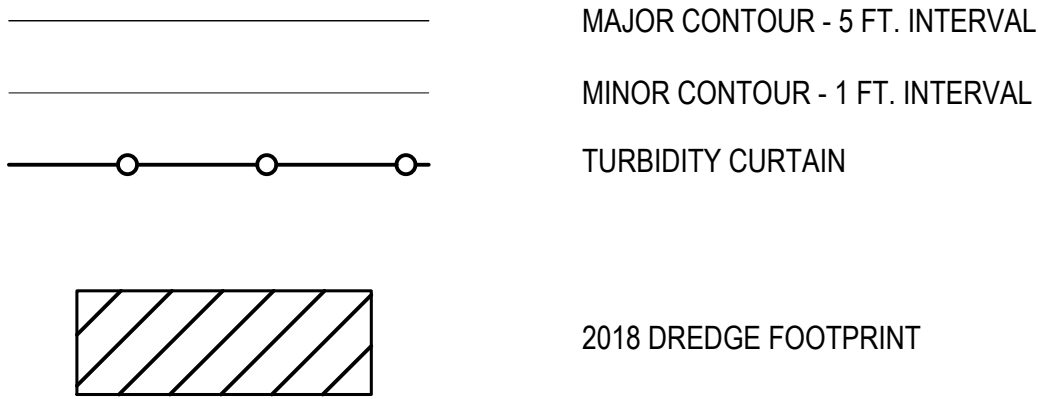

NOTES

- 1) ORDINARY HIGH WATER MARK (OHWM) = 580.5'
- 2) ALL PROPERTY AND/OR RIGHT OF WAY LINES ARE APPROXIMATE.
- 3) ALL QUANTITIES LISTED ARE APPROXIMATIONS.
- 4) INSTALL TURBIDITY CURTAIN AROUND WORK AREA DURING DREDGING OPERATIONS.
- 5) TOPOGRAPHIC SURVEY PROVIDED BY RUSSELL MARINE ENGINEERING & DESIGN LLC ON 06/01/2016.
- 6) SESC BMP'S UTILIZE MICHIGAN KEYING SYSTEM.

SESC MATERIALS SUMMARY


S61 = TURBIDITY CURTAIN

SESC MATERIALS SUMMARY


TURBIDITY CURTAIN A	LF	2500
TURBIDITY CURTAIN B	LF	1950

NOTES:
TYPE OF TURBIDITY CURTAIN TO
BE DETERMINED BY A QUALIFIED
ENGINEER or CPESC.

* JOINTS VARY DEPENDING ON
TYPE OF WATERBODY AND
VELOCITY OF WATERFLOW.

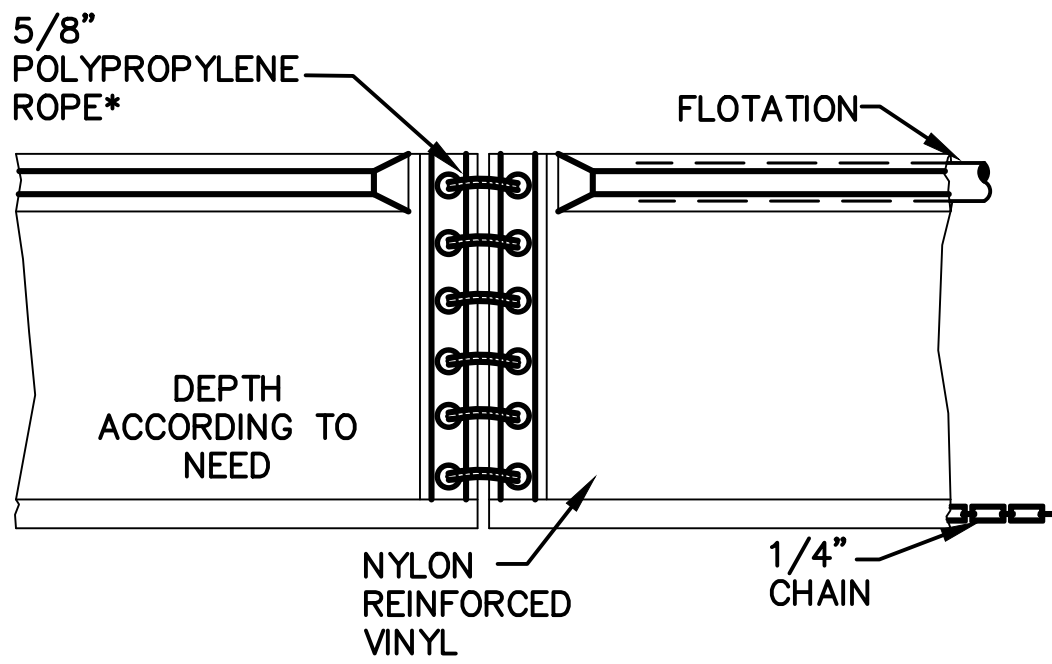

PROFILE – TURBIDITY CURTAIN DETAIL
NOT TO SCALE

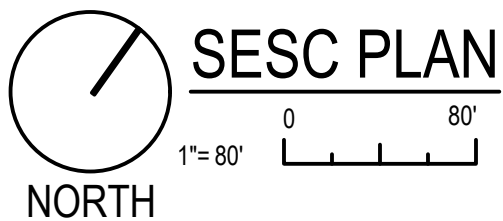

SESC PLAN

AS-BUILT

CONTRACTOR:	RUSSELL MARINE LLC
FIELD ENGINEER:	RICK BUTEYN
INSPECTED BY:	PROGRESSIVE AE
DATE:	09/27/2018



ATTENTION:		11/27/2018	RECORD DRAWINGS	
		08/16/2018	PERMIT MODIFICATION	
		02/06/2018	BIDS & CONSTRUCTION	
		01/12/2018	OWNER REVIEW	
		11/17/2017	OWNER REVIEW	
	0	07/06/2017	DESIGN MODIFICATION	APP
	0	04/07/2017	CONSTRUCTION DOCUMENTS	APP
NO.	DATE	ISSUE/REVISION		APP

Surveyed By: Great Lakes Dock on 06/01/2016
Progressive AE on 09/27/2018

Designed: -
Checked: -
Drawn: -R. Dolweck
Submitted By: -M. Oezer
M.I.P.E. NO.: -41016

Submittal Date:



Progressive AE Project 7008004

MILL DEBRIS FISH & WILDLIFE HABITAT RESTORATION
West Michigan Shoreline Regional Community
Muskegon, Michigan

SESC


DWG NO.

4

ISSUE

0

LEGEND

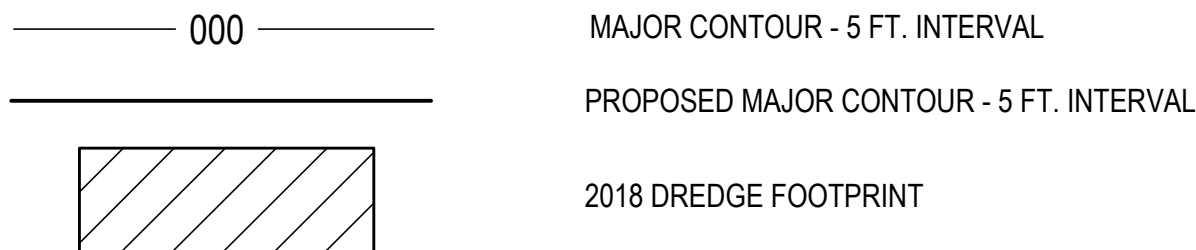

NOTES

- 1) ORDINARY HIGH WATER MARK (OHWM) = 580.5'
- 2) ALL PROPERTY AND/OR RIGHT OF WAY LINES ARE APPROXIMATE.
- 3) ALL QUANTITIES LISTED ARE APPROXIMATIONS.
- 4) EXCAVATE APPROXIMATELY 100,500 CUBIC YARDS OF MARINE DEBRIS FROM 7.0 ACRES WITHIN DREDGE AREAS A & B TO VERTICAL LIMIT OF WOOD DEBRIS, OR AS APPROVED BY ENGINEER.
- 5) GRADE SIDE SLOPES BACK 2(V):1(H) WHERE APPLICABLE.
- 6) CONTRACTOR SHALL STOCKPILE AND DEWATER MATERIAL AT AN APPROVED SITE TO REDUCE MOISTURE CONTENT OF MILL DEBRIS. MATERIAL SHALL BE STOCKPILED AND DRIED A MINIMUM OF 60 DAYS WITH PHYSICAL TURN-OVER OF MATERIAL EVERY 20 DAYS.
- 7) ALL MILL DEBRIS SHALL BE DISPOSED OF IN AN APPROVED TYPE II LANDFILL AFTER DEWATERING AND SHREDDING TO 3 INCH SIZE.
- 8) CONTRACTOR SHALL REMOVE ONLY WOODY MARINE DEBRIS. REMOVAL OF SEDIMENTS AND/OR SAND IS NOT ALLOWED.
- 9) CONTRACTOR SHALL BE RESPONSIBLE FOR CONTAINING AND REMOVING DISLODGED MILL DEBRIS. CONTAINMENT MEASURES SUCH AS TURBIDITY CURTAINS SHALL BE USED TO PREVENT WOOD FROM MIGRATING OUTSIDE THE RESTORATION AREA. ANY DEBRIS THAT DOES MIGRATE OUTSIDE THE RESTORATION AREAS SHALL BE IMMEDIATELY GATHERED AND DISPOSED OF BY THE CONTRACTOR.
- 10) TOPOGRAPHIC SURVEY PROVIDED BY RUSSELL MARINE ENGINEERING & DESIGN LLC ON 06/01/2016.
- 11) ALTERNATE REUSE OF MILL DEBRIS SHALL BE CONSIDERED IF MATERIAL IS DETERMINED TO BE CLEAN BY THE OWNER.

POST DREDGING REPORT

THE FINDINGS OF PROGRESSIVE AE ARE BASED UPON DATA SUPPLIED BY GREAT LAKES DOCK AND MATERIAL, LLC FROM DEPTHS OBTAINED ON 06/27/2018 (PRE-DREDGING) AND ON 09/06/2018 (POST-DREDGING). THIS DATA WAS THEN ANALYZED BY PROGRESSIVE AE TO FIND A DIFFERENCE IN VOLUME AND THEREFORE, CALCULATE HOW MUCH MILL DEBRIS WAS REMOVED FROM LAKE MUSKEGON. FROM THE DATA SUPPLIED BY GREAT LAKES DOCK AND MATERIALS, A REMOVAL VOLUME OF 56,513 CY WAS CALCULATED. THIS DIFFERS FROM THE SUBMITTED TOTAL VOLUME OF 55,018 CY, A DIFFERENCE OF 2.7% VOLUME.

AS-BUILT

CONTRACTOR: RUSSELL MARINE LLC
FIELD ENGINEER: RICK BUTEYN
INSPECTED BY: PROGRESSIVE AE
DATE: 09/27/2018

AS-BUILT RESTORATION SUMMARY

ITEM	UNIT	QTY	UNIT	QTY
DREDGE AREA A	ACRES	4.0	CY	42,205
DREDGE AREA B	ACRES	3.0	CY	12,813
TOTALS	ACRES	7.0	CY	55,018

PROPOSED CONDITIONS

NORTH 1"= 80'



ATTENTION:	11/27/2018	RECORD DRAWINGS	
	08/16/2018	PERMIT MODIFICATION	
	02/06/2018	BIDS & CONSTRUCTION	
	01/12/2018	OWNER REVIEW	
	11/17/2017	OWNER REVIEW	
	07/06/2017	DESIGN MODIFICATION	APP
	04/07/2017	CONSTRUCTION DOCUMENTS	APP
NO.	DATE	ISSUE/REVISION	APP

Surveyed By: Great Lakes Dock on 06/01/2016
Progressive AE on 09/27/2018

Designed: -

Checked: -

Drawn: -R. Dolweck

Submitted By: - M. Oezer

M.I.P.E. NO.: - 41016

Submittal Date:



Progressive AE Project 7008004

MILL DEBRIS FISH & WILDLIFE HABITAT RESTORATION
West Michigan Shoreline Regional Community
Muskegon, Michigan

PROPOSED CONDITIONS


DWG NO.

5


ISSUE

0

A—A

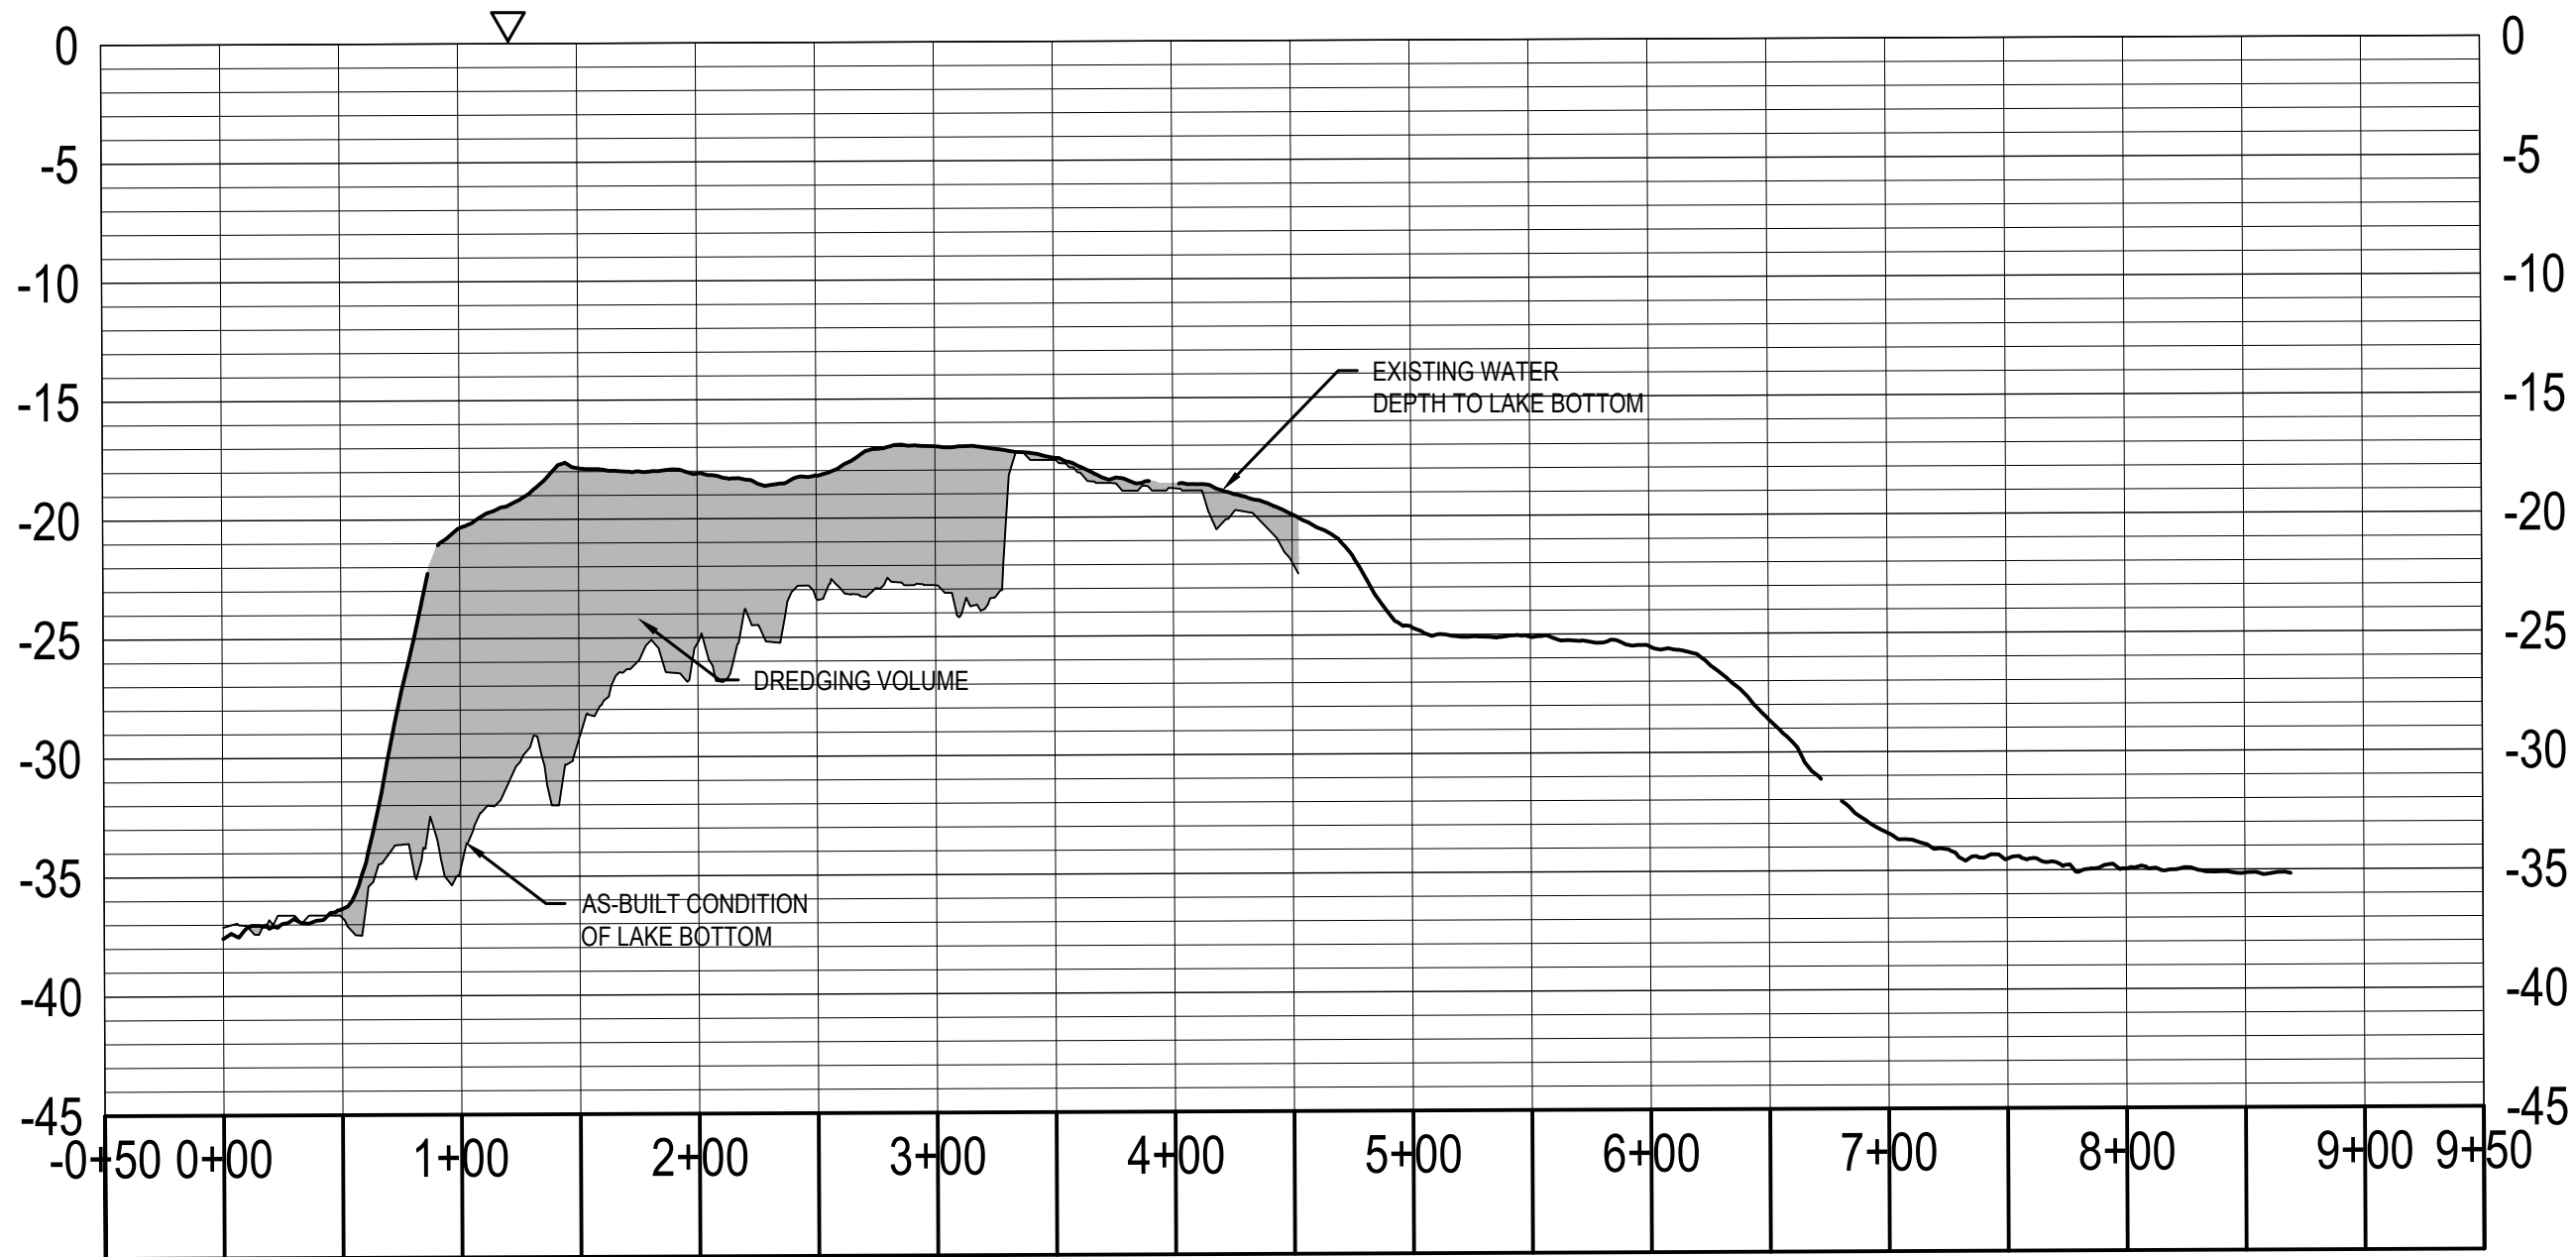

LEGEND

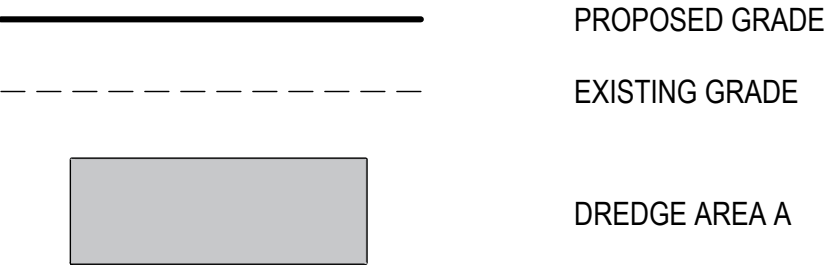


NOTES


- 1) SIDE SLOPES OF DREDGE AREA ARE 2(V):1(H)
- 2) VERTICAL SCALE IS EXAGGERATED 10X.
- 3) LIMIT OF MARINE DEBRIS REMOVAL IS 36.5' BELOW WATER SURFACE ELEVATION.

AREA A SECTIONS

A—B

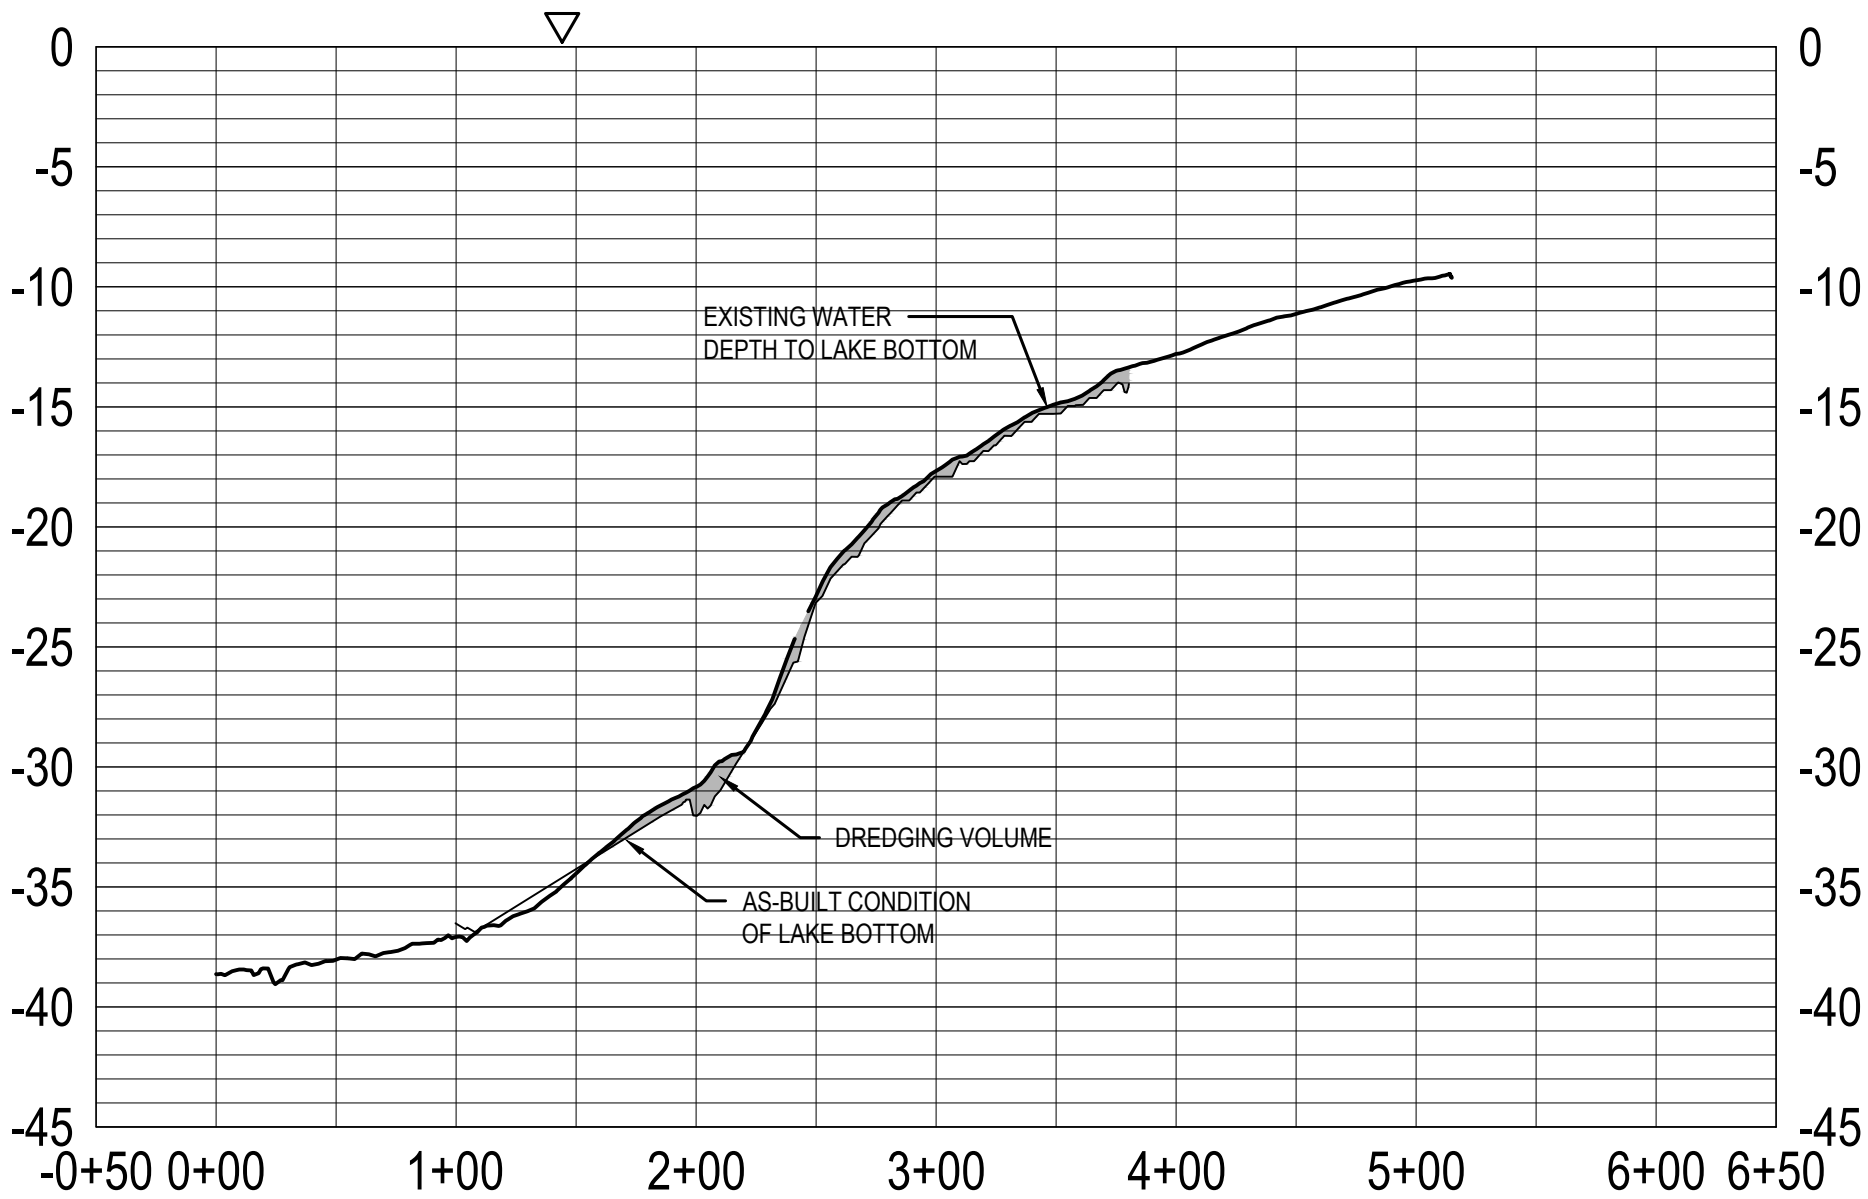


A—C

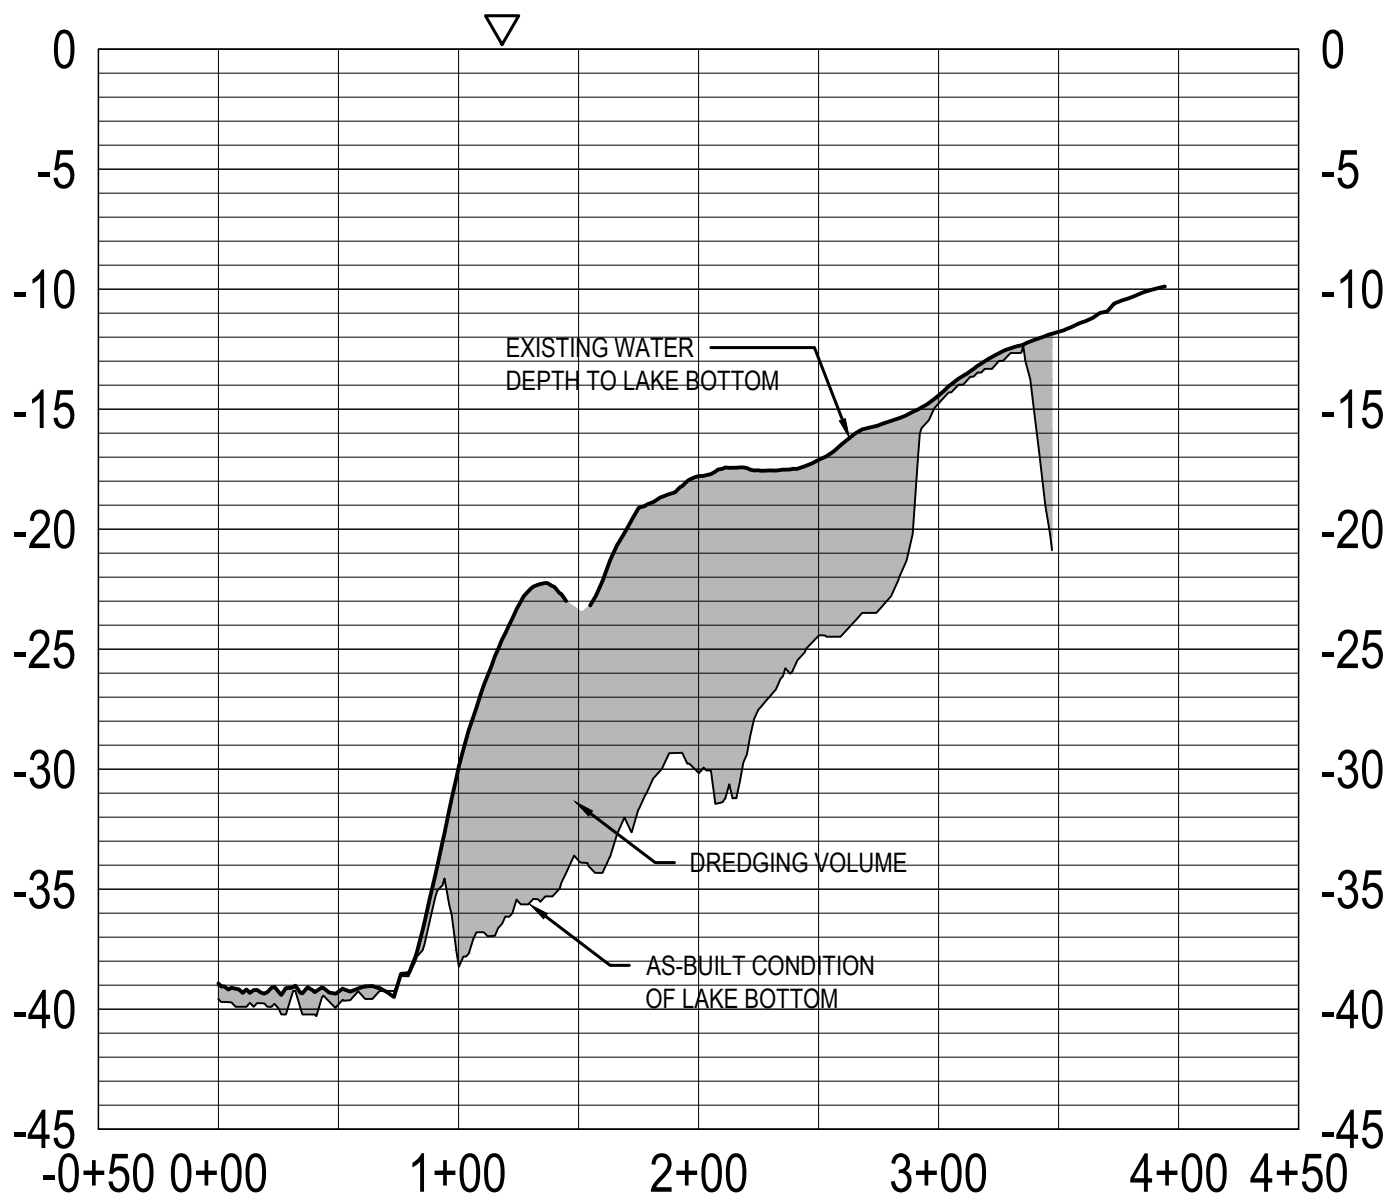

AS-BUILT

CONTRACTOR:	RUSSELL MARINE LLC
FIELD ENGINEER:	RICK BUTEYN
INSPECTED BY:	PROGRESSIVE AE
DATE:	09/27/2018

CROSS-SECTIONS:
DREDGE AREA A

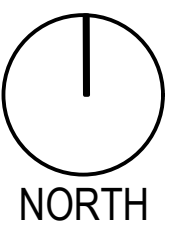

SCALE
HORZ. 1"=80'
VERT. 1"=8'



ATTENTION:	11/27/2018	RECORD DRAWINGS	
	08/16/2018	PERMIT MODIFICATION	
	02/06/2018	BIDS & CONSTRUCTION	
	01/12/2018	OWNER REVIEW	
	11/17/2017	OWNER REVIEW	
	07/06/2017	DESIGN MODIFICATION	APP
	04/07/2017	CONSTRUCTION DOCUMENTS	APP
NO.	DATE	ISSUE/REVISION	APP

Surveyed By: Great Lakes Dock on 06/01/2016
Progressive AE on 09/27/2018

Designed: -
Checked: -
Drawn: -R. Dolweck
Submitted By: -M. Oezer
M.P.E. NO.: -41016

Submittal Date:



Progressive AE Project 7008004

MILL DEBRIS FISH & WILDLIFE HABITAT RESTORATION
West Michigan Shoreline Regional Community
Muskegon, Michigan

DWG NO.


6

CROSS-SECTIONS:
DREDGE AREA A


ISSUE

0

B—A

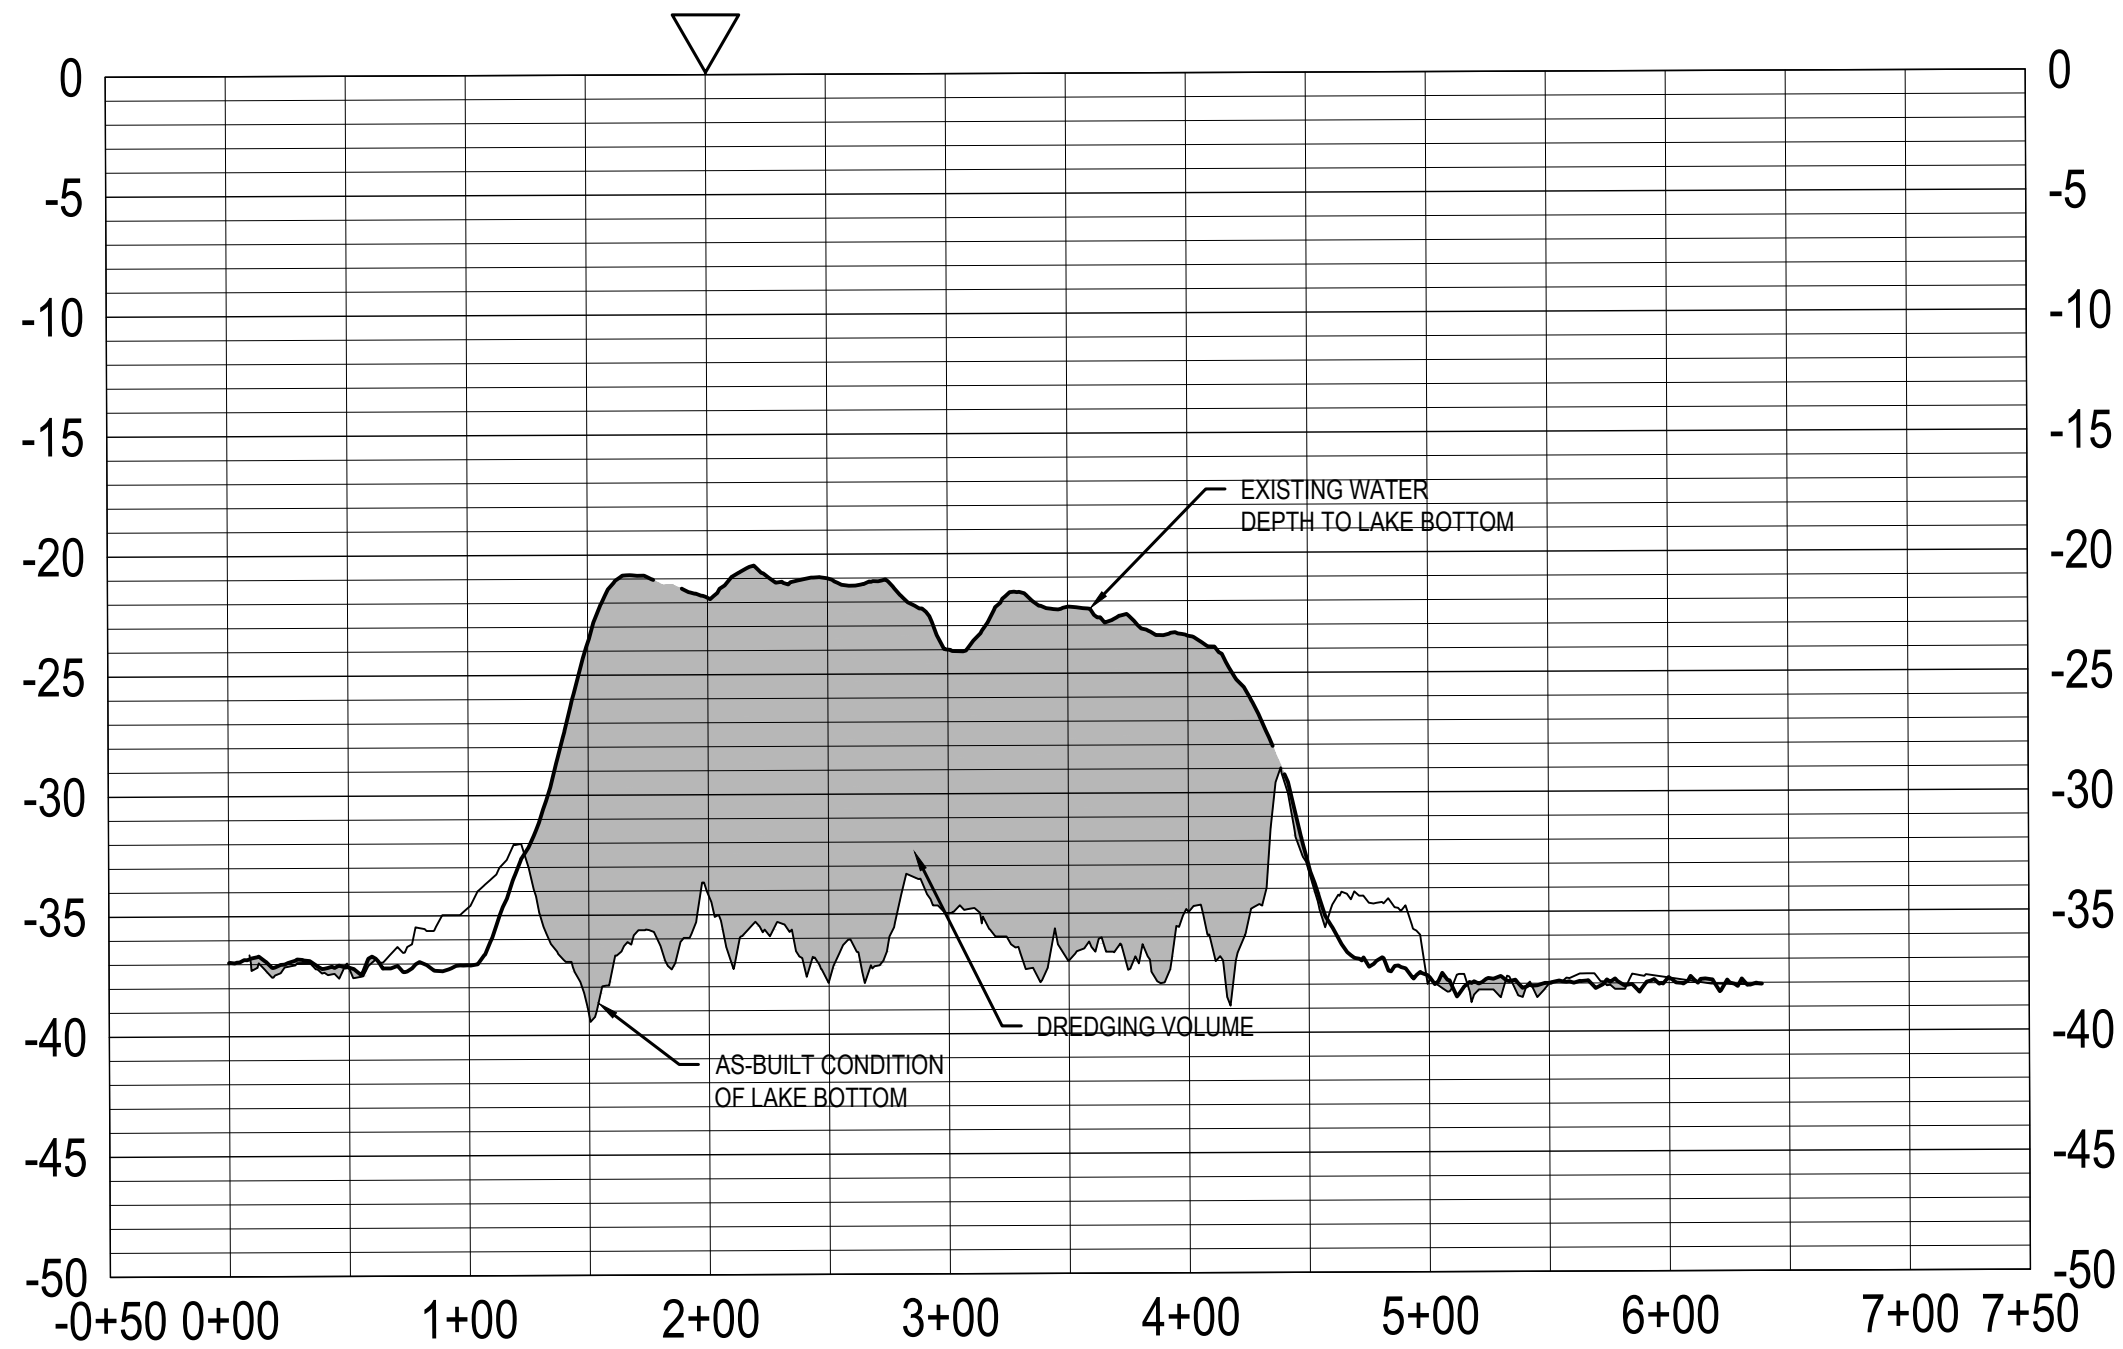

LEGEND

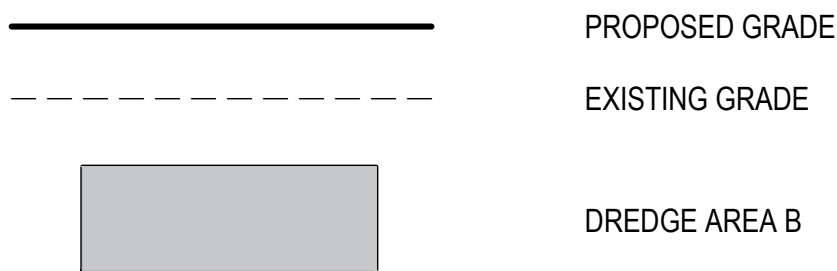


NOTES


- 1) SIDE SLOPES OF DREDGE AREA ARE 2(V):1(H)
- 2) VERTICAL SCALE IS EXAGGERATED 10X.
- 3) LIMIT OF MARINE DEBRIS REMOVAL IS 38' BELOW WATER SURFACE ELEVATION.

AREA B SECTIONS

B—B

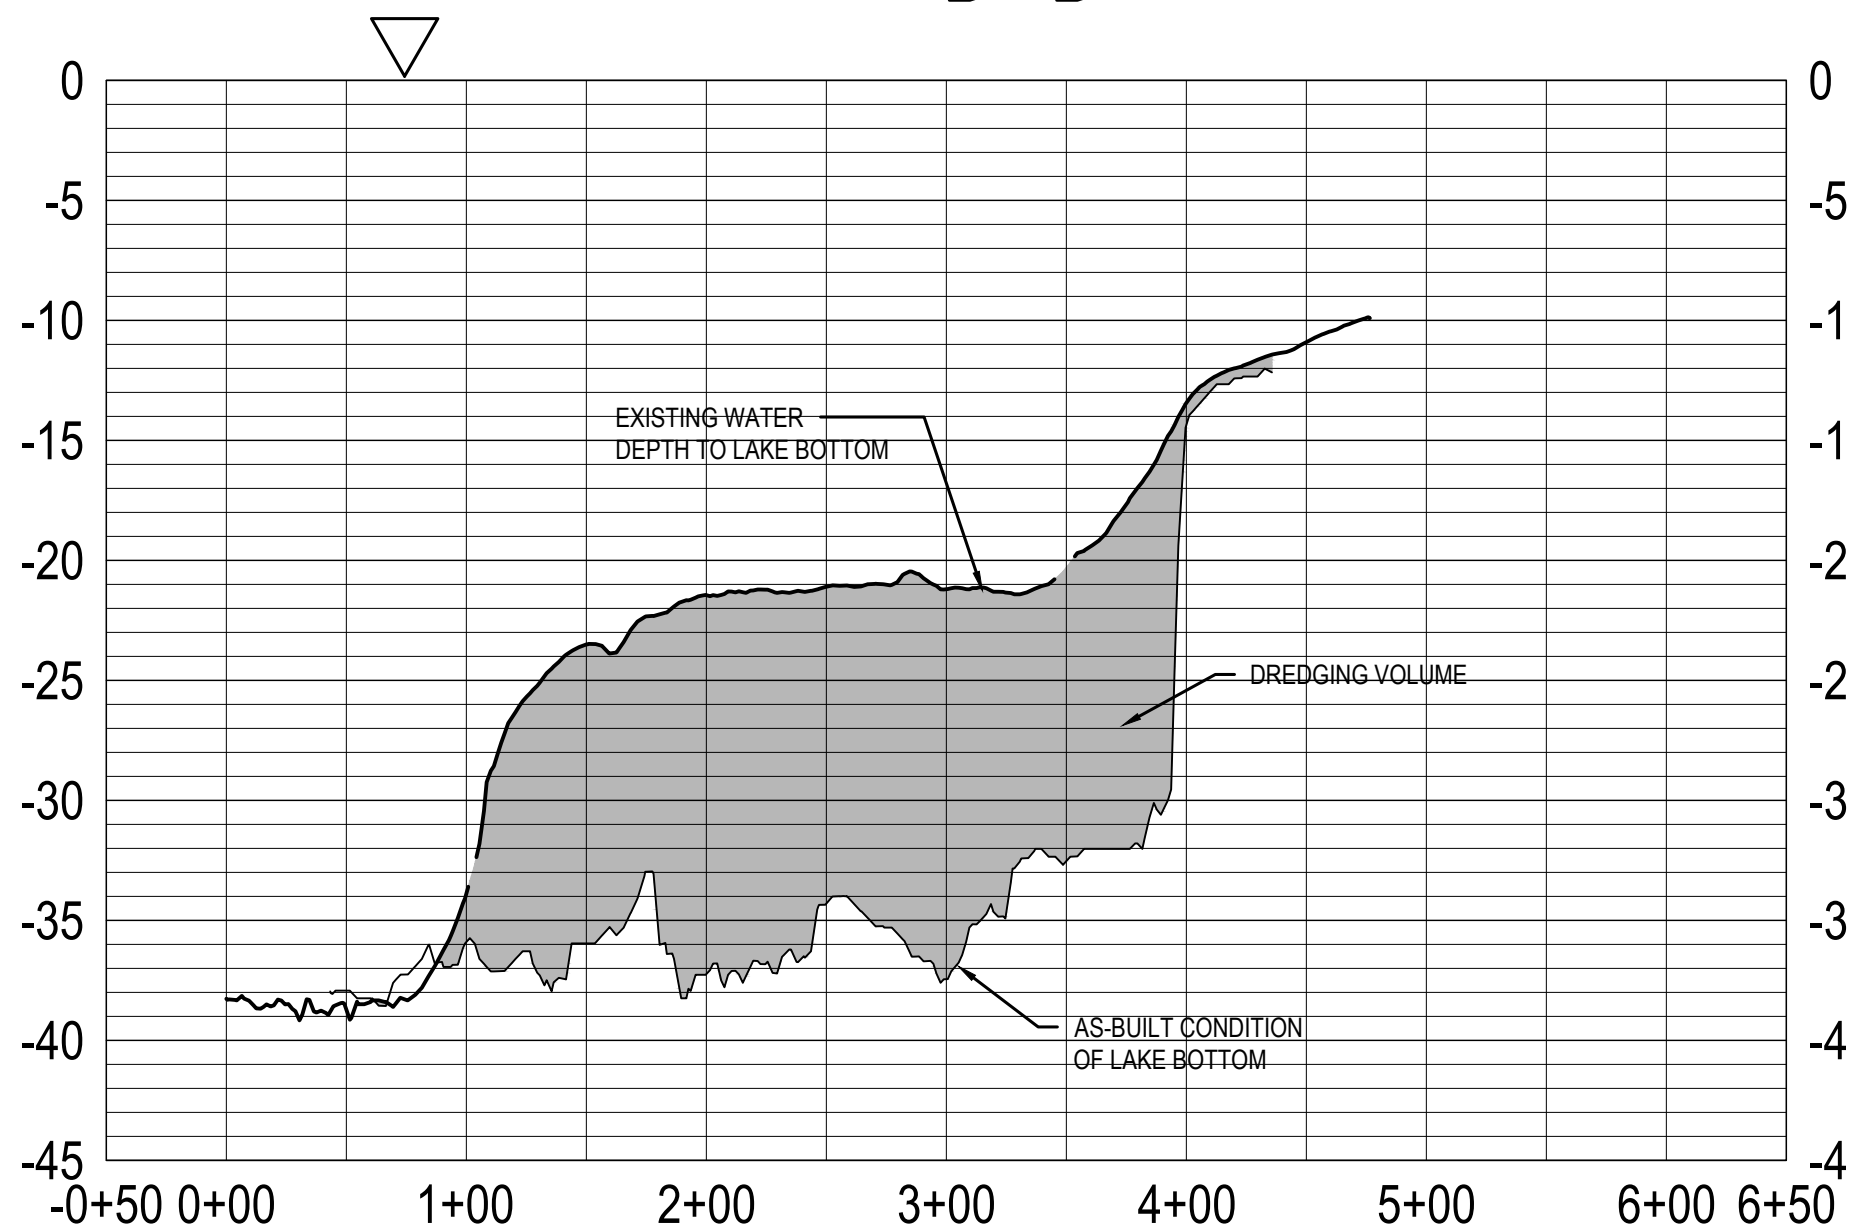


B—C

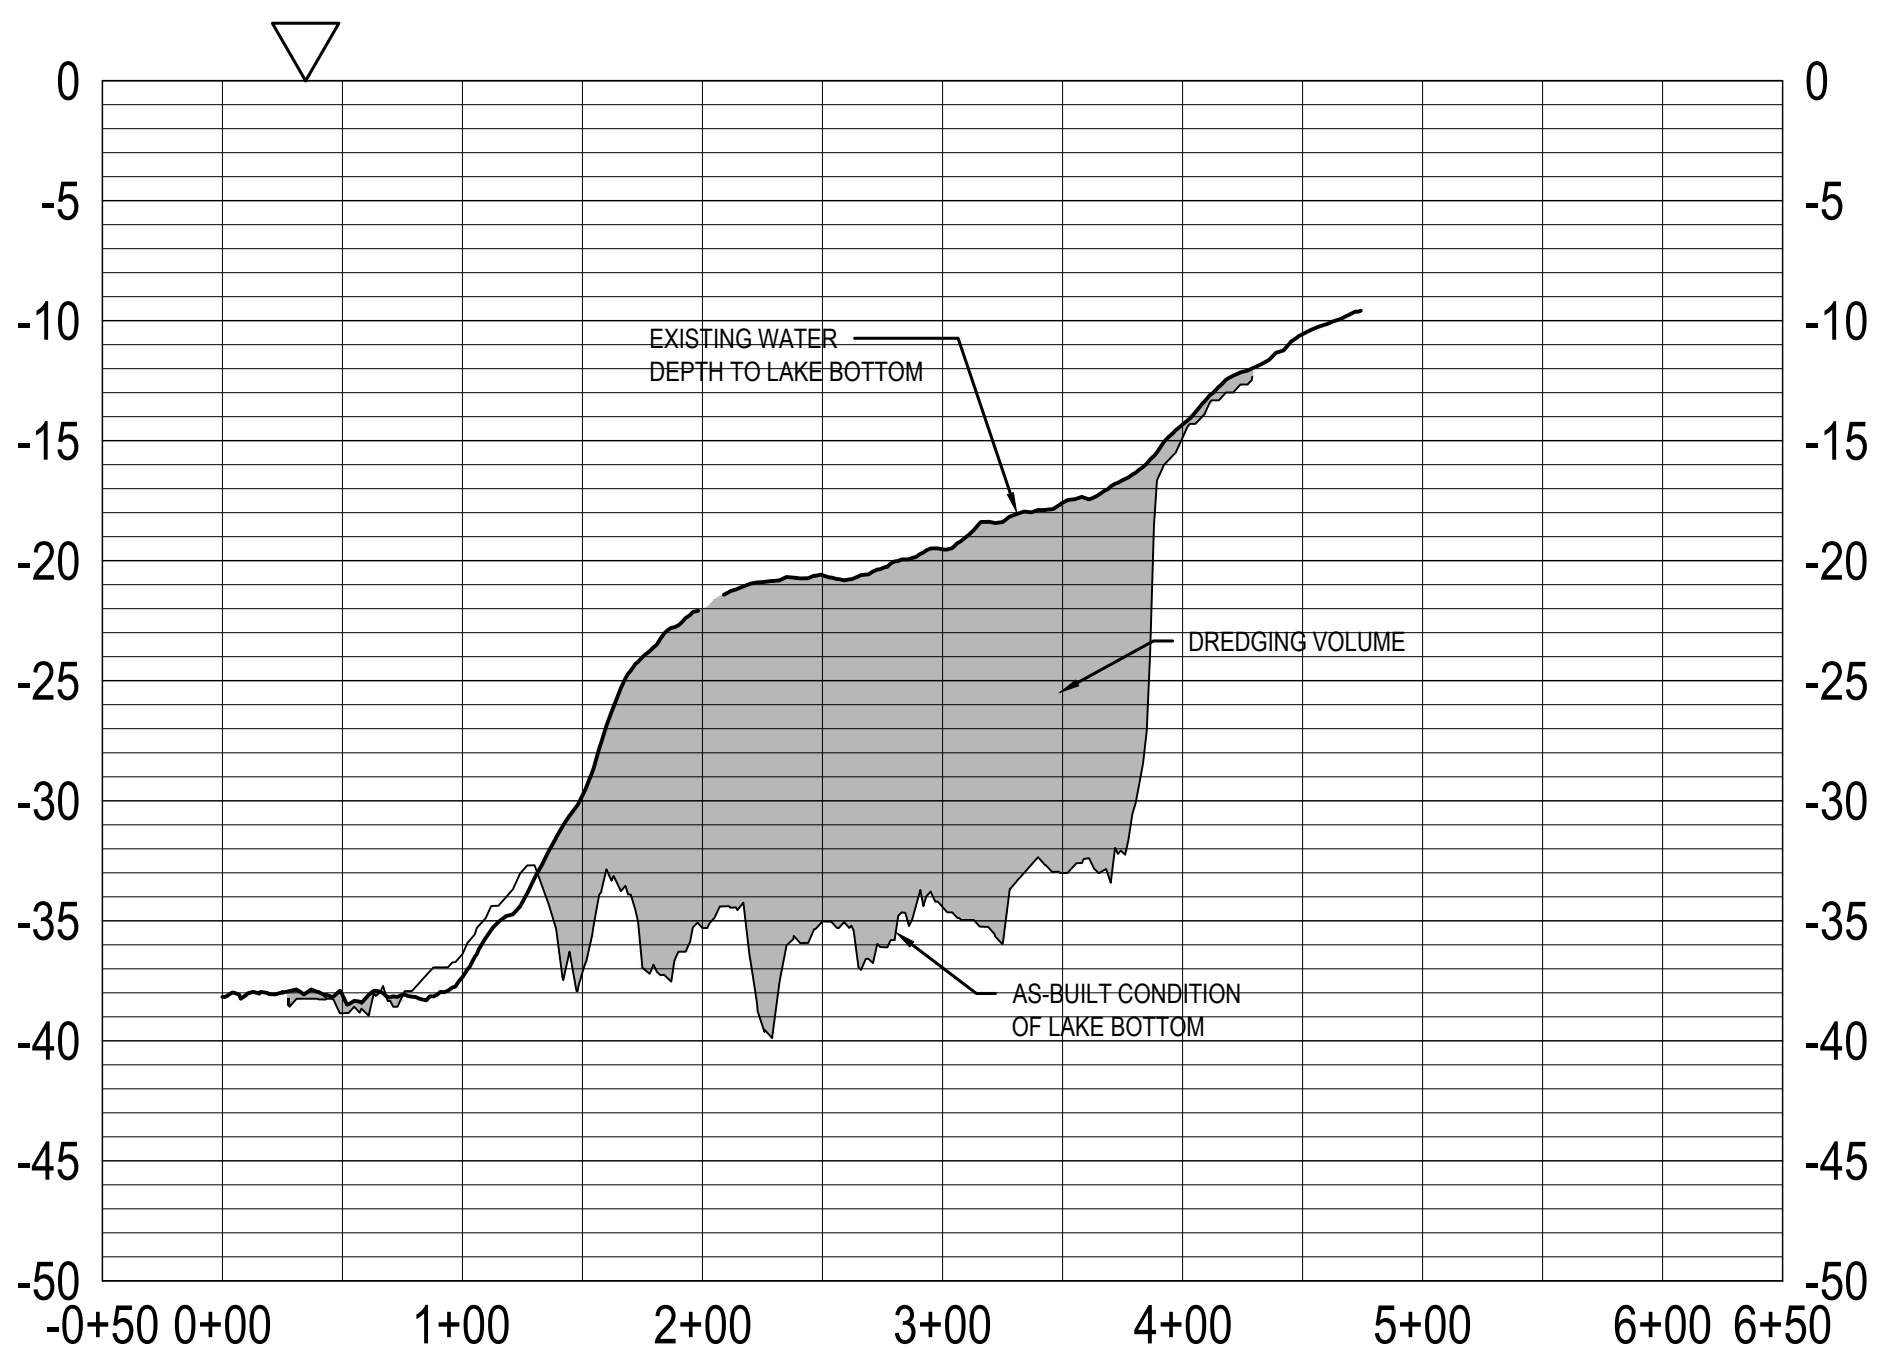

AS-BUILT

CONTRACTOR:	RUSSELL MARINE LLC
FIELD ENGINEER:	RICK BUTEYN
INSPECTED BY:	PROGRESSIVE AE
DATE:	09/27/2018

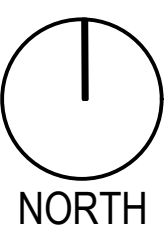

CROSS-SECTIONS:
DREDGE AREA B

SCALE
HORZ. 1"=80'
VERT. 1"=8'



ATTENTION:	11/27/2018	RECORD DRAWINGS	
	08/16/2018	PERMIT MODIFICATION	
	02/06/2018	BIDS & CONSTRUCTION	
	01/12/2018	OWNER REVIEW	
	11/17/2017	OWNER REVIEW	
	07/06/2017	DESIGN MODIFICATION	APP
	04/07/2017	CONSTRUCTION DOCUMENTS	APP
NO.	DATE	ISSUE/REVISION	APP

Surveyed By: Great Lakes Dock on 06/01/2016
Progressive AE on 09/27/2018

Designed: -
Checked: -
Drawn: -R. Dolweck
Submitted By: -M. Oezer
M.P.E. NO.: -41016

Submittal Date:

progressive|ae



Progressive AE Project 7008004

MILL DEBRIS FISH & WILDLIFE HABITAT RESTORATION
West Michigan Shoreline Regional Community
Muskegon, Michigan

CROSS-SECTIONS:
DREDGE AREA B

DWG NO.

7

ISSUE

0